


As Built – Dimension Set 5-17
Prime Mover 1-8 (8-FWO-0)& Trailer Set 2.

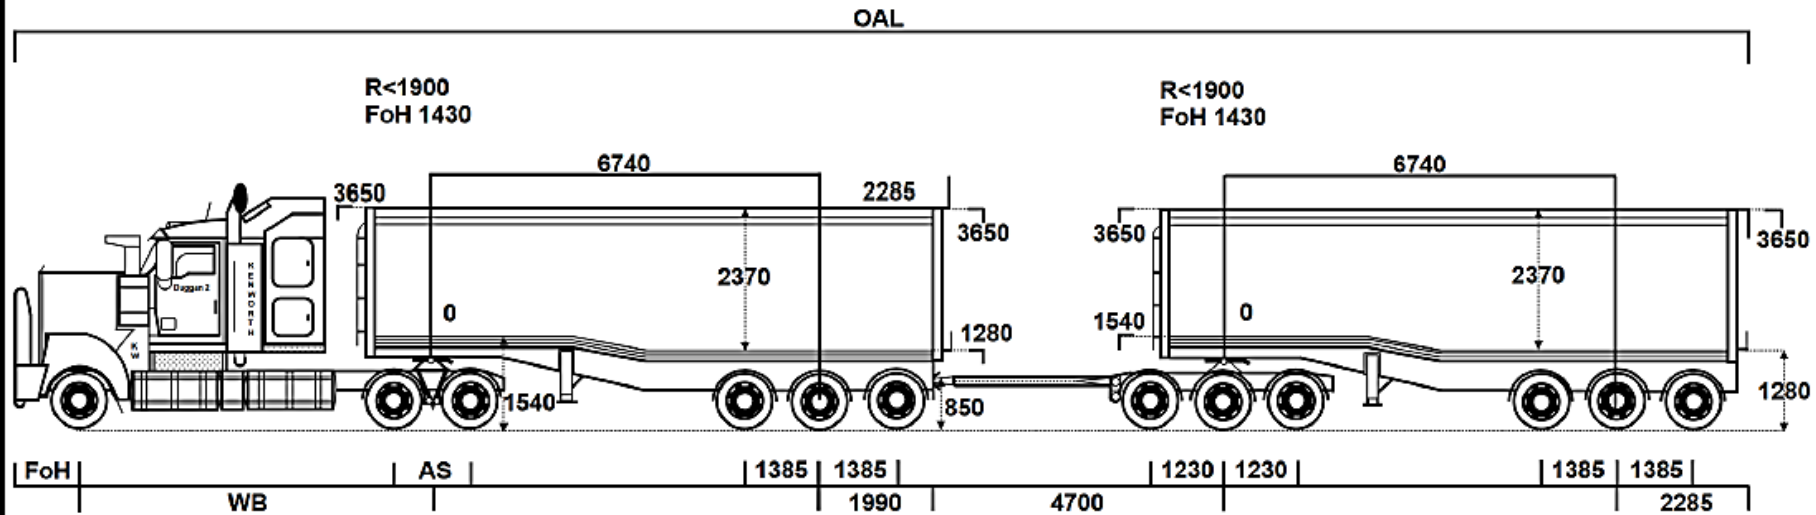

PM	FoH	WB	AS	OAL	PM	FoH	WB	AS	OAL
1	1090	5790	1320	29,335	5	1100	5600	1320	29,155
2	1450	5400	1320	29,305	6	1450	5790	1450	29,695
3	1090	6120	1435	29,665	7	1285	5860	1440	29,600
4	1100	6100	1320	29,655	8	1090	6180	1450	29,725

					 NEBCOH AUDITORS AND CERTIFIERS	
Title	2-DU-11-23	2	12-9-2025	NEBCOH		
	Dwg. No.	Rev.	Date	Author		