


As Built dimension set dimension set 1.
Prime mover 1- 3 & Trailer set 1.

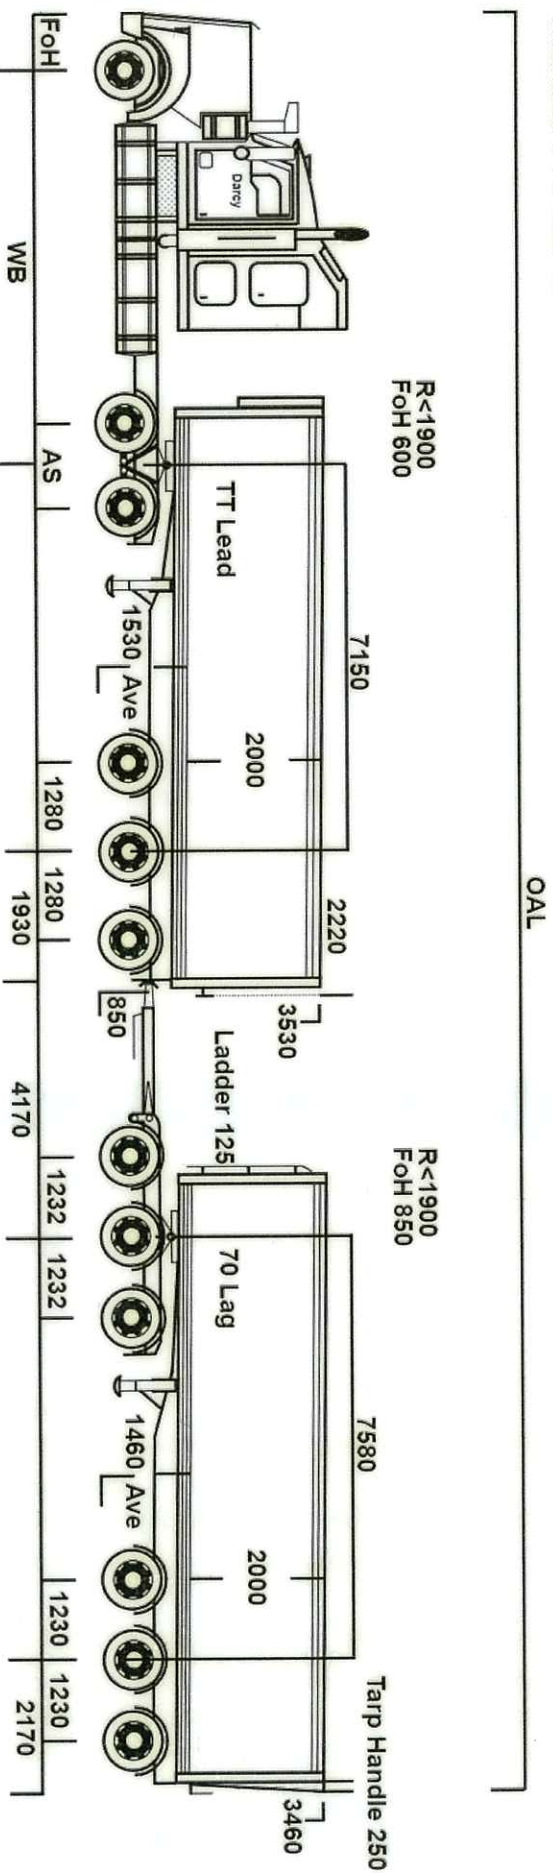

Prime mover	FoH	WB	AS	TT Lead	OAL
Prime mover 1	1000	5850	1320	50 Lag	29,970
Prime mover 2	875	5790	1450	150	29,585
Prime mover 3	1080	5530	1320	0	29,680