
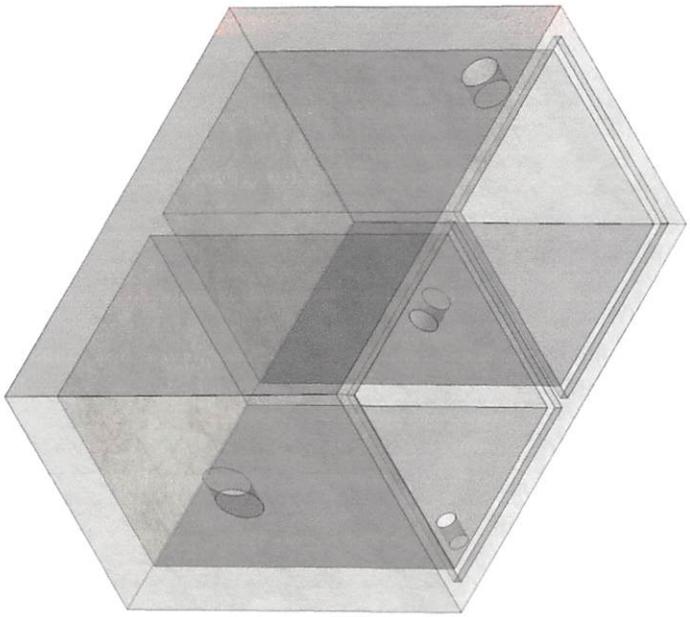


2028-5

OROM HOLDINGS 2500GAL 2 COMPARTMENT SUMP
VOLUME: 192 GAL
WEIGHT: 3726 LBS

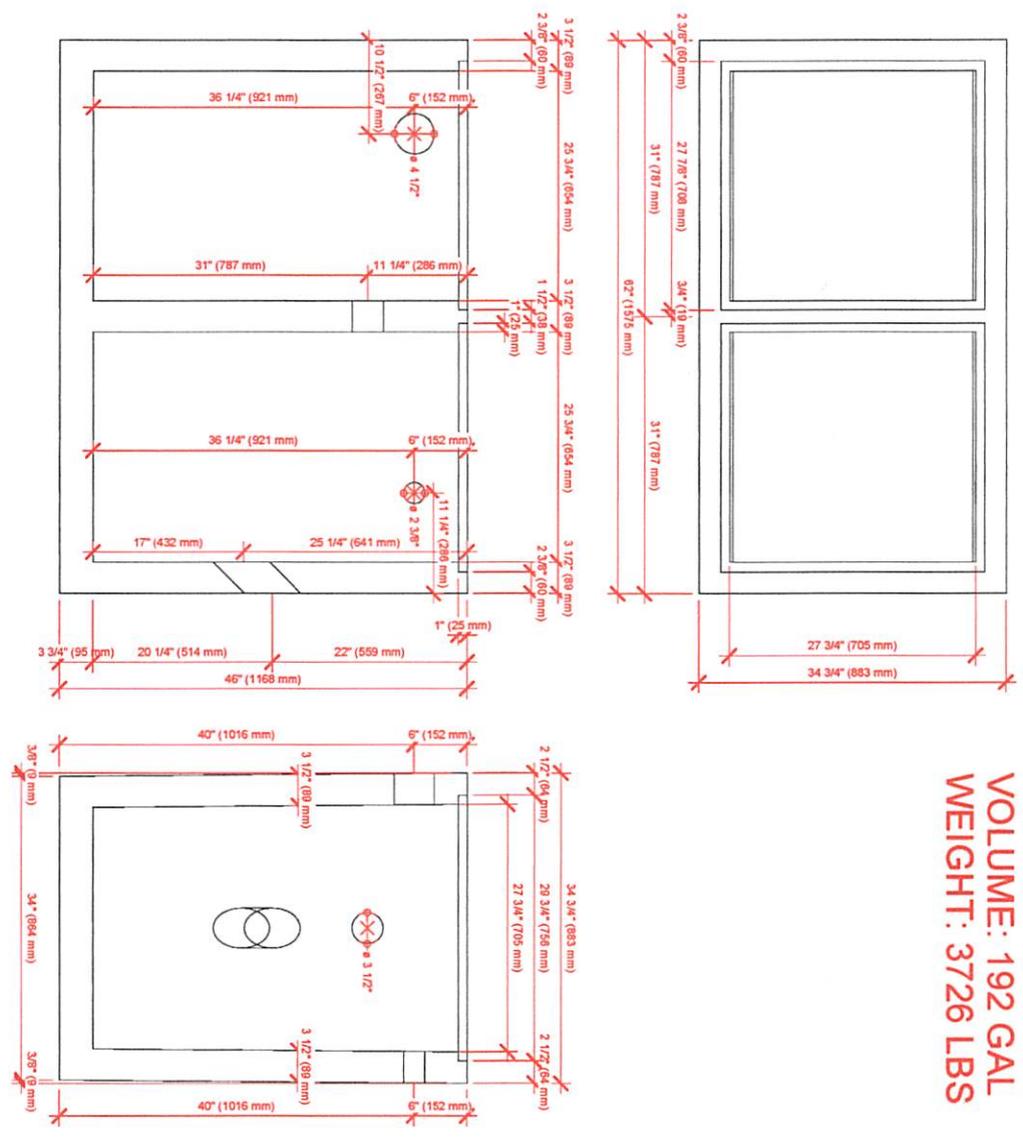

Date:	12/04/19	Drawn By:	JR	Job No.:	-	Job Name:	2 COMPARTMENT SUMP
Rev:	0	Sheet Number:	S05				

WORLD CLASS CONTRACTORS, LTD.
 Mechanical Contractors
 10000 104th Ave S, Suite 100
 Richmond, BC V6V 2G9
 Tel: 604-273-8888



Shop Drawing Submittal

Attention:	DERRICK BENTLEY (SCOTT BUILDERS) & HARRY WOLLIN (TMP ENGINEERING)
Submittal No.:	M5
No. of Pages:	2
Project:	CANDRE CANNABIS
Date:	SEPT 10.18
Trade:	WCC
Section:	PLUMBING

Items Submitted:

SUMP PIT

Review Comments / Stamps:

1. provide hole between chambers complete with venting to meet code.



Consulting Engineers

Job No. **18-226-000**

In 27Sep18	Out 27Sep18
Reviewed CNW	Reviewed with comments
	Resubmit see comments

REVIEWED FOR GENERAL ARRANGEMENT ONLY AND SUBJECT TO ANY REVISIONS SHOWN MATERIAL, WORKMANSHIP, DIMENSIONS, FIELD CLEARANCES & DESIGN SHALL BE IN ACCORDANCE WITH REQUIREMENTS OF CONTRACT DOCUMENTS.

Approved By:

Date: **SEPT 10.18**

Name: **WILL DEERING**

Signature: 

Two Chambered Concrete Double Garage Sump

Nominal Dimensions

- Height: 46"
- Width: 34"
- Length: 62"
- Inlet: 37"
- Outlet: 26.5"

