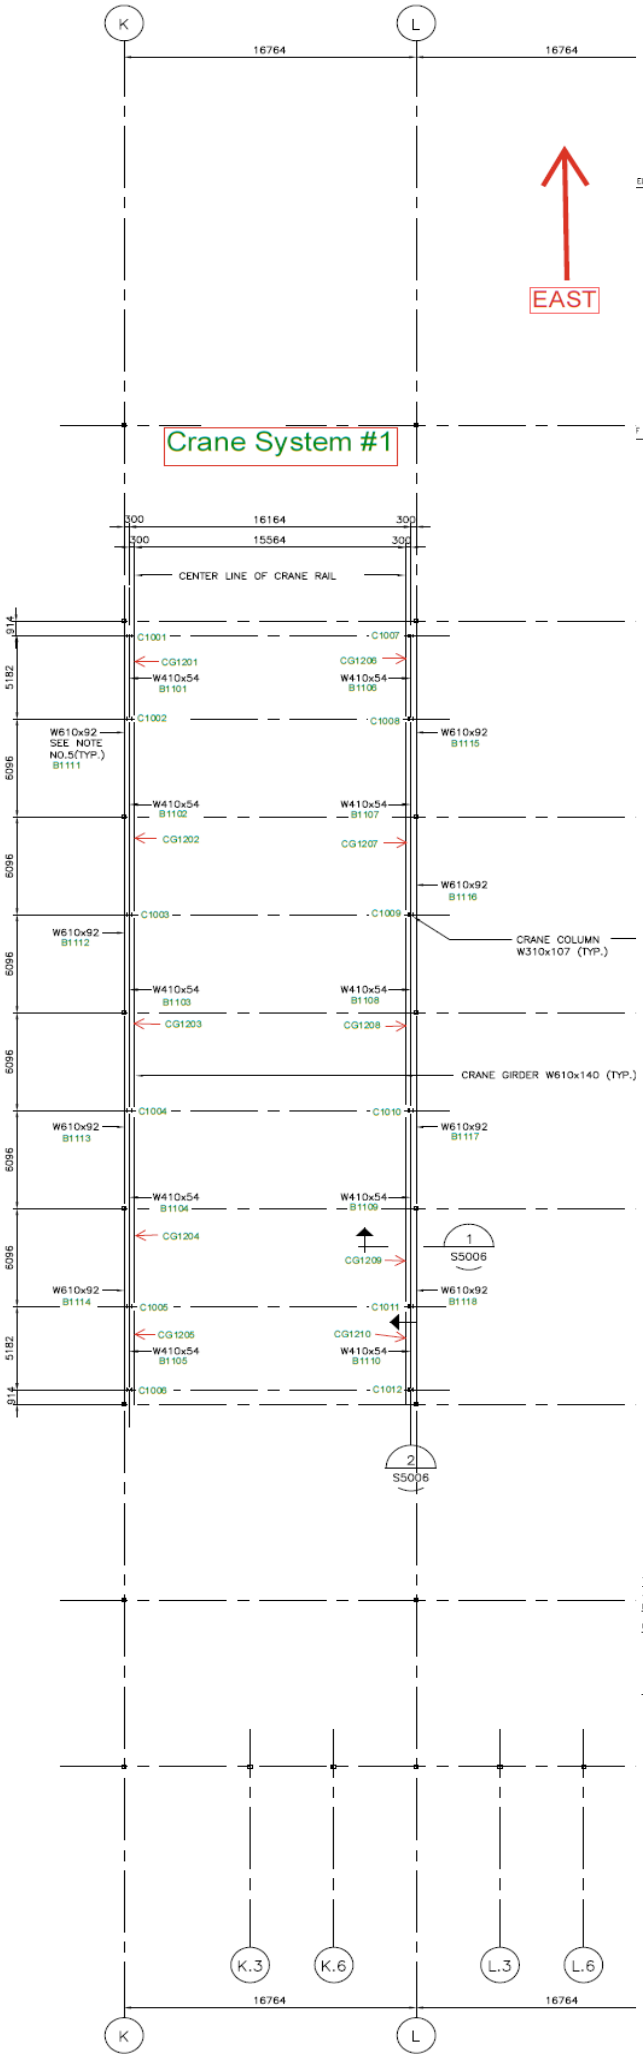

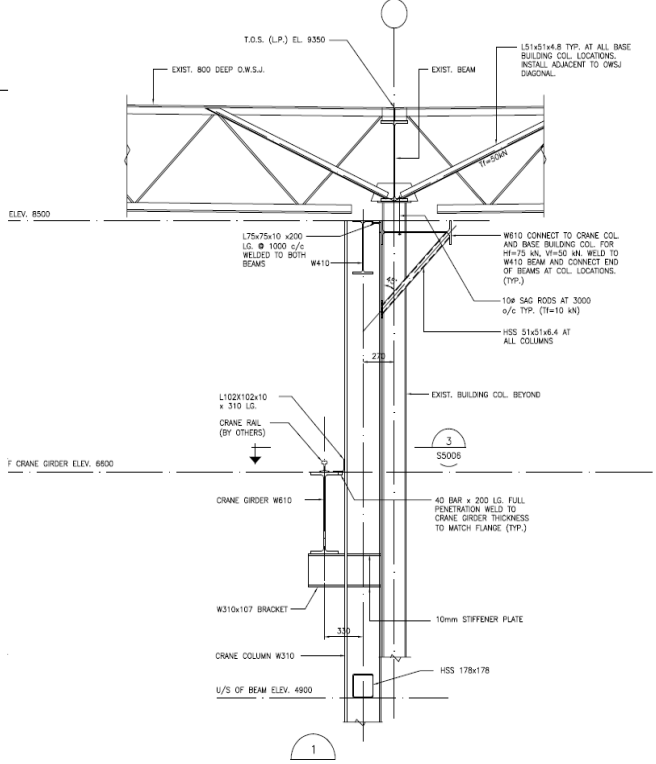

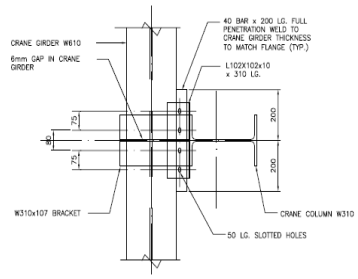

3 S5006 PLAN DETAIL SCALE 1:10

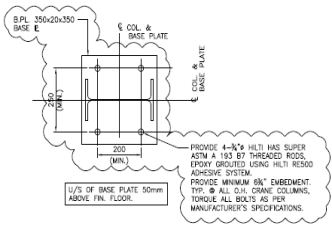

4 S5006 BASE PLATE DETAIL SCALE 1:10

NOTE: SITE MEASURE FOR AS-BUILT LOCATION OF ANCHOR BOLTS (TYP.)

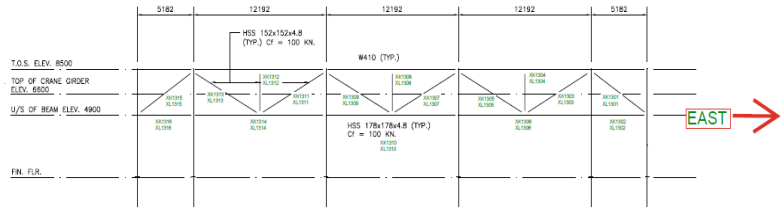

Crane #1 ELEVATION ON LINE 'L'
ELEVATION ON LINE 'K' (OPPOSITE HAND)
SCALE 1:200

NOTE: OTHER MEMBERS NOT SHOWN FOR CLARITY.